Tuesday, 8/1/2006 11:31:36 AM

User:

Kim Johnston

## **Process Sheet**

Customer

: CU-DAR001 Dart Helicopters Services

Job Number

: 28083

**Estimate Number** 

: 11082

P.O. Number

:NIA

This Issue

Written By

Comment

: 8/1/2006

Prsht Rev.

First Issue **Previous Run** 

Checked & Approved By

S.O. No. : NIM

Type

: MACHINED PARTS

: Est Rev:E

Re-Format

05-11-29 JLM **Drawing Name** 

: INNER AFT SADDLE

Part Number

: D5957

**Drawing Number** 

: D5957 REV A : N/A

Project Number **Drawing Revision** 

:NIA

Material Due Date : 8/31/2006

Qty:

4 Um:

Each

**Additional Product** 

Job Number:



Seq. #:

1.0

2.0

**Machine Or Operation:** 

Description:

D6101007

7075-T7351 8.25X7.75X2.5



1.0000 Each(s)/Unit Comment: Qty.:

D6101-007(7075-T7351)

4.0000 Each(s)

Size 2.50" x 7.50" X 8.25" (Grain along 7.50")

Batch: HAAS3



Comment: HAAS CNC VERTICAL MACHINING #3

1-Machine as per folio D5957,Ensure Batch Number is entered J.L

Total:

2-Machine Keyway PTO

3-Deburr & Tumble

06/11/109

3.0

QC1

INSPECT ALL DIM TO DIM SHEET



Comment: INSPECT ALL DIM TO DIM SHEET



4.0

QC8

SECOND CHECK



Comment: SECOND CHECK

HAND FINISHING RESOURCE

5.0

Comment: HAND FINISHING RESOURCE #1

Chemical Conversion Coat as per QSI 005 4.1



t Aerospace L	td
---------------	----

<u>, 5:</u>		WORK ORDER CHANGES					
DATE	STEP	PROCEDURE CHANGE	Ву	Date	Qty	Approval Mfg / Design Mgr	Approval QC Inspector
06-11:03	2	CHAMFER 0.033 x 45° WAS ADDED AND CALLED (). SIMFLEAD TO 0.1571.	06.11.63				E
		SEE ATTACHED					06.11.03

NCR:		WORK ORDER NON-CONFORMANCE (NCR)								
		Description of NC		Verification		Annaval				
DATE	STEP	Section A	Initial Design Mgr	Action Description  Design Mgr	Sign & Date	Section C	Approval Design Mgr	Approval QC Inspector		
						·				
-				· 						

Part No:	PAR #:	Fault Category: NCR:	Yes No DQA:	Date: <u>06/11/</u>	11
NOTE: Date & initial all entries			QA: N/C Closed:	Date:	4)

Date: Tuesday, 8/1/2006 11:31:37 AM ₄User: Kim Johnston **Process Sheet** Drawing Name: INNER AFT SADDLE Customer: CU-DAR001 Dart Helicopters Services Job Number: 28083 Part Number: D5957 Job Number: Description: Seq. #: **Machine Or Operation:** POWDER COATING POWDER COATING Comment: POWDER COATING Powder Coat White Gloss (Ref: 4.3.5.1) as per QSI 005 4.3 INSPECT POWDER COAT/CHEMICAL CONVERSION 7.0 POWDER COAT/CHEMICAL CONVERSION PACKAGING 1 PACKAGING RESOURCE #1 8.0 Comment: PACKAGING RESOURCE #1 Identify and Stock Location: DC 9.0 Comment: DOCUMENT CONTROL Inspection Level 21 Job Completion (Local III 16

## **Dart Aerospace Ltd**

W/O:		WORK ORDER CHANGES							
DATE	STEP	PROCEDURE CHANGE	Ву	Date	Qty	Approval Mfg / Design Mgr	Approval QC Inspector		

NCR:		WORK ORDER NON-CONFORMANCE (NCR)								
		Description of NC		Corrective Action Section B		Verification	A	A		
DATE	STEP	Section A	Initial Design Mgr	Action Description  Design Mgr	Sign & Date	Section C	Approval Design Mgr	Approval QC Inspector		
						}				
							,			
				· ·						

Part No:	PAR #:	Fault Category: NCR:	Yes	No	DQA:	Date:	•
NOTE: Date & initial all entries	**		QA:	N/C C	losed:	Date:	, 4.

DART AEROSPACE LTD	Work Order:	28083
Description: Inner Aft Saddle	Part Number:	D5957
Inspection Dwg: D5957 Rev. A		Page 1 of 1

Inspect dimensions highlighted on inspection sheet drawing D5957 Rev. A and record below:


<u> </u>			ingrited off inspe	Recorded Actual Dimensions				1"	
Dim	Min	Max	Go/No Go Gauge	1	2	3	4	Ву	Date
Α	0.438	0.443	<del>₽∓868</del> 2	6.440	0-440		0.440		
- B	1.745	1.755		1.752	1.781	1.751	1.750		
~ C	5.245	5.255		5.24	B 3 30	5 2 50	5.249		
<sup>2</sup> D	6.995	7.005		7.001	7.000	7.001	7.001		
E	5.745	5.755		5.746	5.747	5.747	5.746		
F	4.745	4.755		4.749	4.749	4.749	4-749		
G	0.313	0.318	<del>- D∓800</del> 6	0.315	0.314	0.317	0.314		
Н	1.522	1.532		1.525	1.528	1.527	1-527		
1	3.048	3.058		3054	3.054	3.054			
J	4.575	4.585		4.579	4.579	4.579	4-580		
K	0.313	0.318	<b>₹₽∓863</b> 6	0.315	0.314	0.314	0.314		
¥ L	0.240	0.260		0.558	0.260	0.360	0 259		
M	0.490	0.510		0.502	0-501	0.500	0 - 500		
ř N	0.240	0.260	:	0.258	0.266	0 260	0.259		
- 0	7.990	8.010		8.003	8003	8.003	8.004		
Р	0.240	0.260		6.243	0.244	8.003	0.255		
٤Q	0.307	0.312		0.311	0-312	U.314	0 - 319		
R	0.760	0.765		0.7-65		0.764	0-761		
S	0.490	0.510		0.498	0,499	0.500	0.448		
T	1.625	1.645		1.632	1.632	1-632	1.632		
U	2.000	2.020	-D <del>T8698 A/</del> B	2.000	2-066	2,000	2.000		
3 V	0.023	0.043		0.030	0.030	0.030	0.030		
W									
X				,					
Y									
Z									
AA									
AB									
AC					,				
AD								•	<u></u>
AE									
AF									
AG	**	,							
AH									: <u>.</u>
	Acc	cept/Reje	ct						


	·
Measured by: 6/3.6	Audited by J. F.
Date: 06/11/10	Date: 06/1//0

Γ	Rev	Date	Change	Revised by	Approved
	Α	99.04.19	New Issue	RF	
	В	02.12.13	Reformat; Added Dim. T-U & DT8682, DT8686 & DT8696 A/B	KJ/RF	#





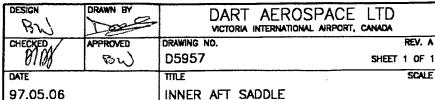

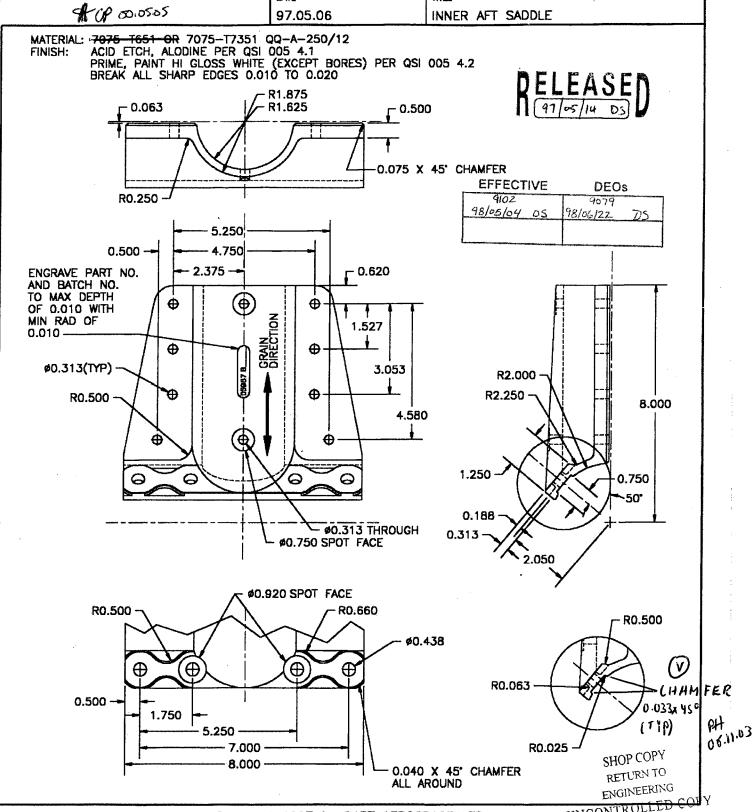

Copyright 1997 by DART AEROSPACE LTD

UNCONTRULLED COILY
SUBJECT TO AMENDMENT
WITHOUT NOTICE

WORK 000 3

## Peter Hum

From:

David Shepherd [dshepherd@dartaero.com]

Sent:

November 3, 2006 10:22 AM

To:

'Peter Hum'

Subject: RE: D5951/D5953/D5955/D5957

This change is acceptable to me.

David

From: Peter Hum [mailto:phum@dartaero.com] Sent: Thursday, November 02, 2006 2:33 PM

To: 'David Shepherd'

**Subject:** D5951/D5953/D5955/D5957

David,

Last year we made a change to the ridges on the 205 saddles (we made a 0.033" X 45 degree chamfer) which I've attached.

Production is making a run of the extended high gear saddles D5951/D5953/D5955/D5957. Can the changes made to the 205 saddles be applied to the x-tended high gear saddles?

The extended high gear goes onto the same D205-634 skidtubes

Chris Bell is currently updating the D5951/D5953/D5955/D5957 saddles and if this change is acceptable, we will add it in

Peter

No virus found in this incoming message.

Checked by AVG Free Edition.

Version: 7.1.409 / Virus Database: 268.13.23/513 - Release Date: 11/2/2006

No virus found in this outgoing message.

Checked by AVG Free Edition.

Version: 7.1.409 / Virus Database: 268.13.23/513 - Release Date: 11/2/2006

